




		FIELD BOOK	PAGE															15	MISCELLANEOUS CHANGES	09-21-21							SUN		M.S. 46-85, 46-86	ALL ELEVATIONS M.S.L.	SHEET NO. M SCALE: 1" = 50' ____ OF ____ SHTS		
		8352	6A, 7A, 11A, 30A, 31A, 56A, 57A															14	AS-BUILT ANOMALY REPAIR #7 & #8	03-17-08							JM		LOCATION: FUEL OIL SYSTEM - LONG BEACH				
		10035	55, 62, 63															13	ADDED AGM #5.5 AT STA. 908+35	04-23-07							JM		16" LINE 514 STA 899+90 TO STA 912+30 LAKEWOOD TO PIPEBRIDGE VALVE BOX				
		10062	73															12	ANOMALY REPAIR #3 (PPS 84 #0684026)	12-27-06							JM						
590124	INDEX MAPS	10331	12, 13, 14, 15 & 16															11	AS BUILT & ADDED REP. #95-20,95-21,95-22,95-23 & 95-24	07/01/96		TSL	EAM		AH	1745							
590123	INDEX MAPS																	10	REDRAWN AND GENERAL REVISIONS	11-24-86		GGV	TRS		MP	4748							
REFERENCE DRAWINGS		REFERENCE DRAWINGS		NO.	REVISIONS				DATE	P.E.	QAE	SUPV	APPROVED	ENGR	CK'D	MADE	I.D.	NO.	REVISIONS				DATE	P.E.	QAE	SUPV	APPROVED	ENGR	CK'D	MADE		I.D.	<i>Zenith Energy West Coast Terminals LLC</i>

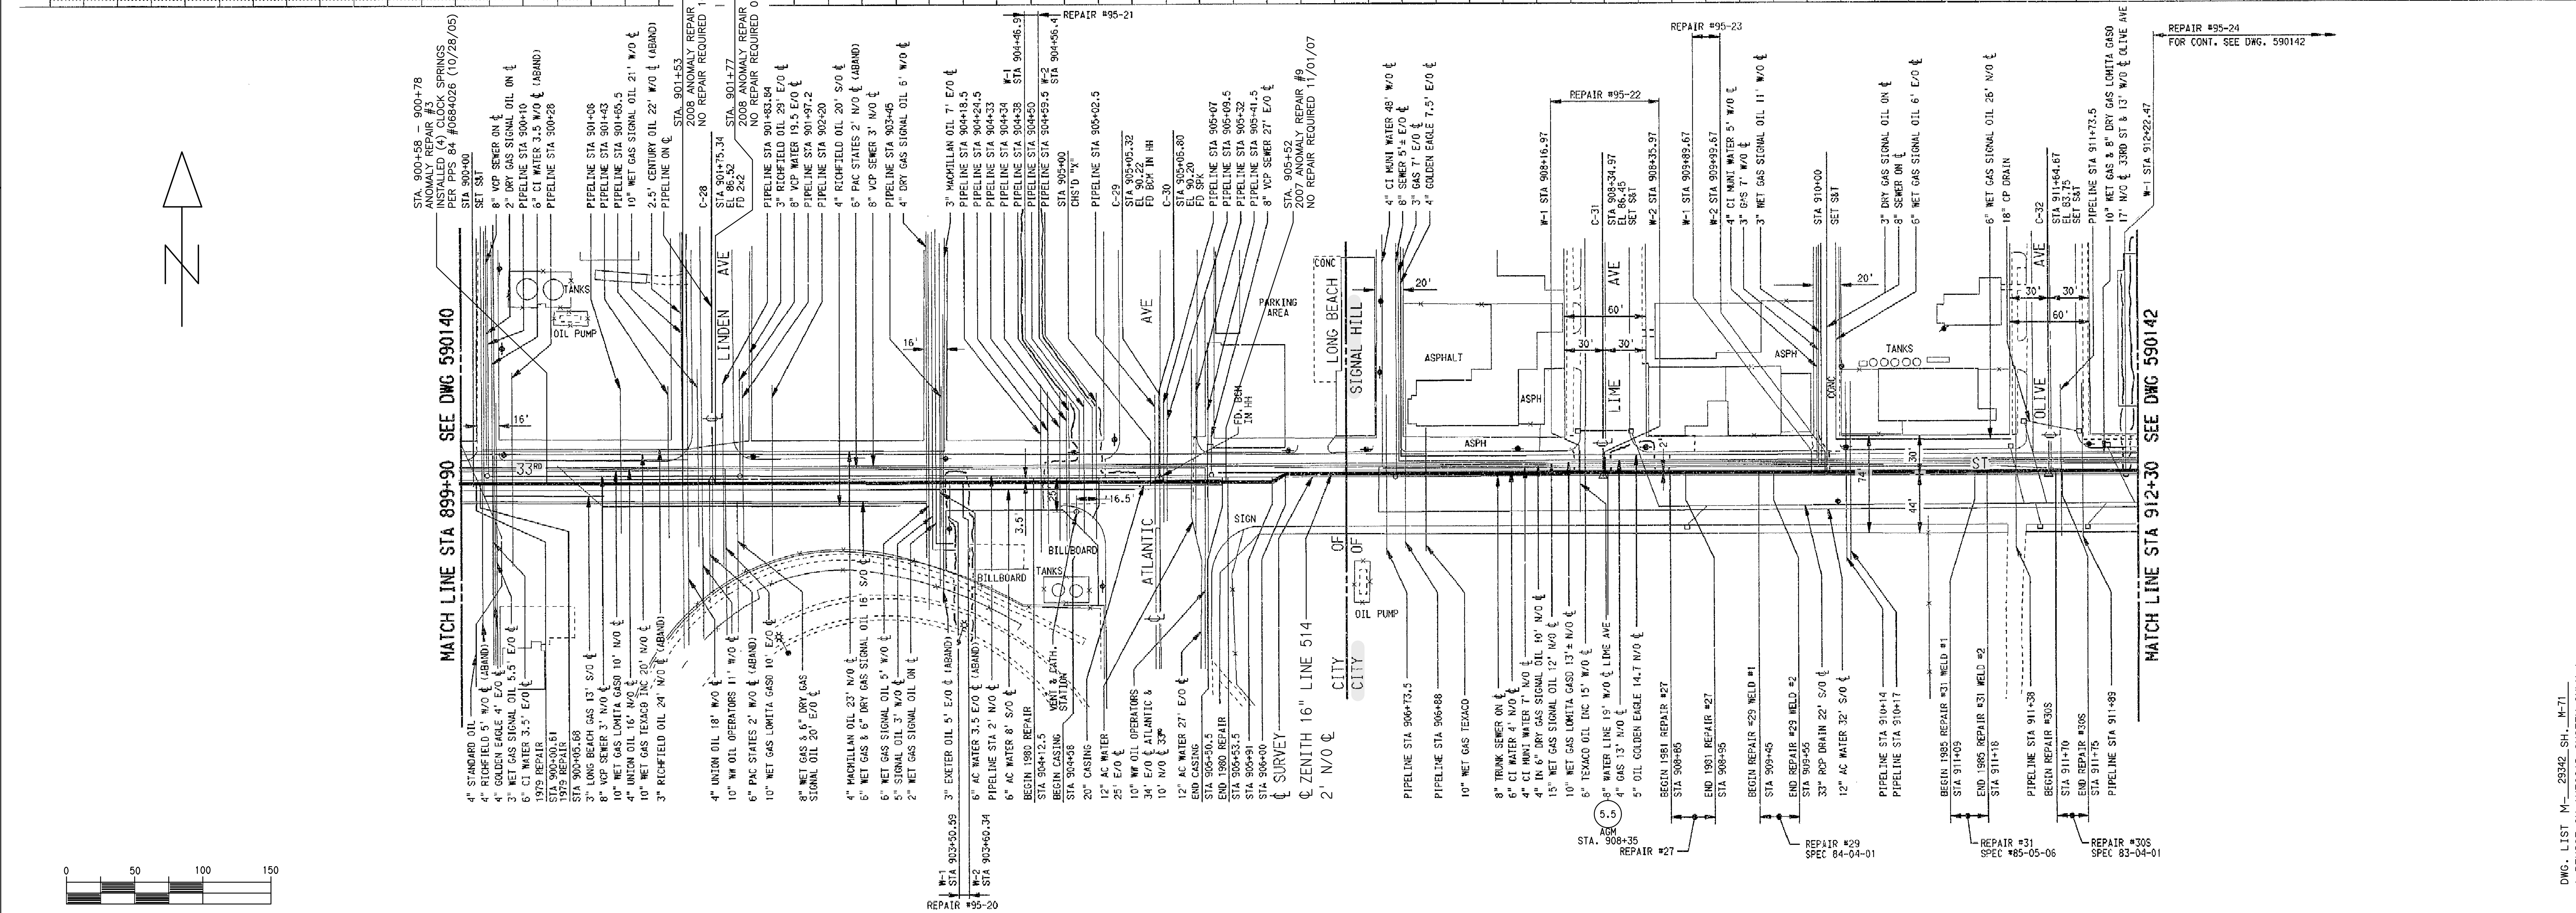